

REVISIONS:	
No	DESCRIPTION

A3 SHEET = NTS
REV 0

129 pax

TOTAL AREA
866 sqm

CLIENT:

THE BUSINESS EXCHANGE

PROJECT NAME:

TBE CENTURY CITY


INFORMATION


DESIGNED:	CHECKED:	PROJECT NO:
DATE:	DRAWN:	SCALE:
03-03-2025	MW	A3 @ NTS
DRAWING DESCRIPTION:		

AS BUILT FLOOR LAYOUT

FIRST FLOOR

DRAWING NUMBER:	REVISION:
TBE-CC-01-10-AB	00

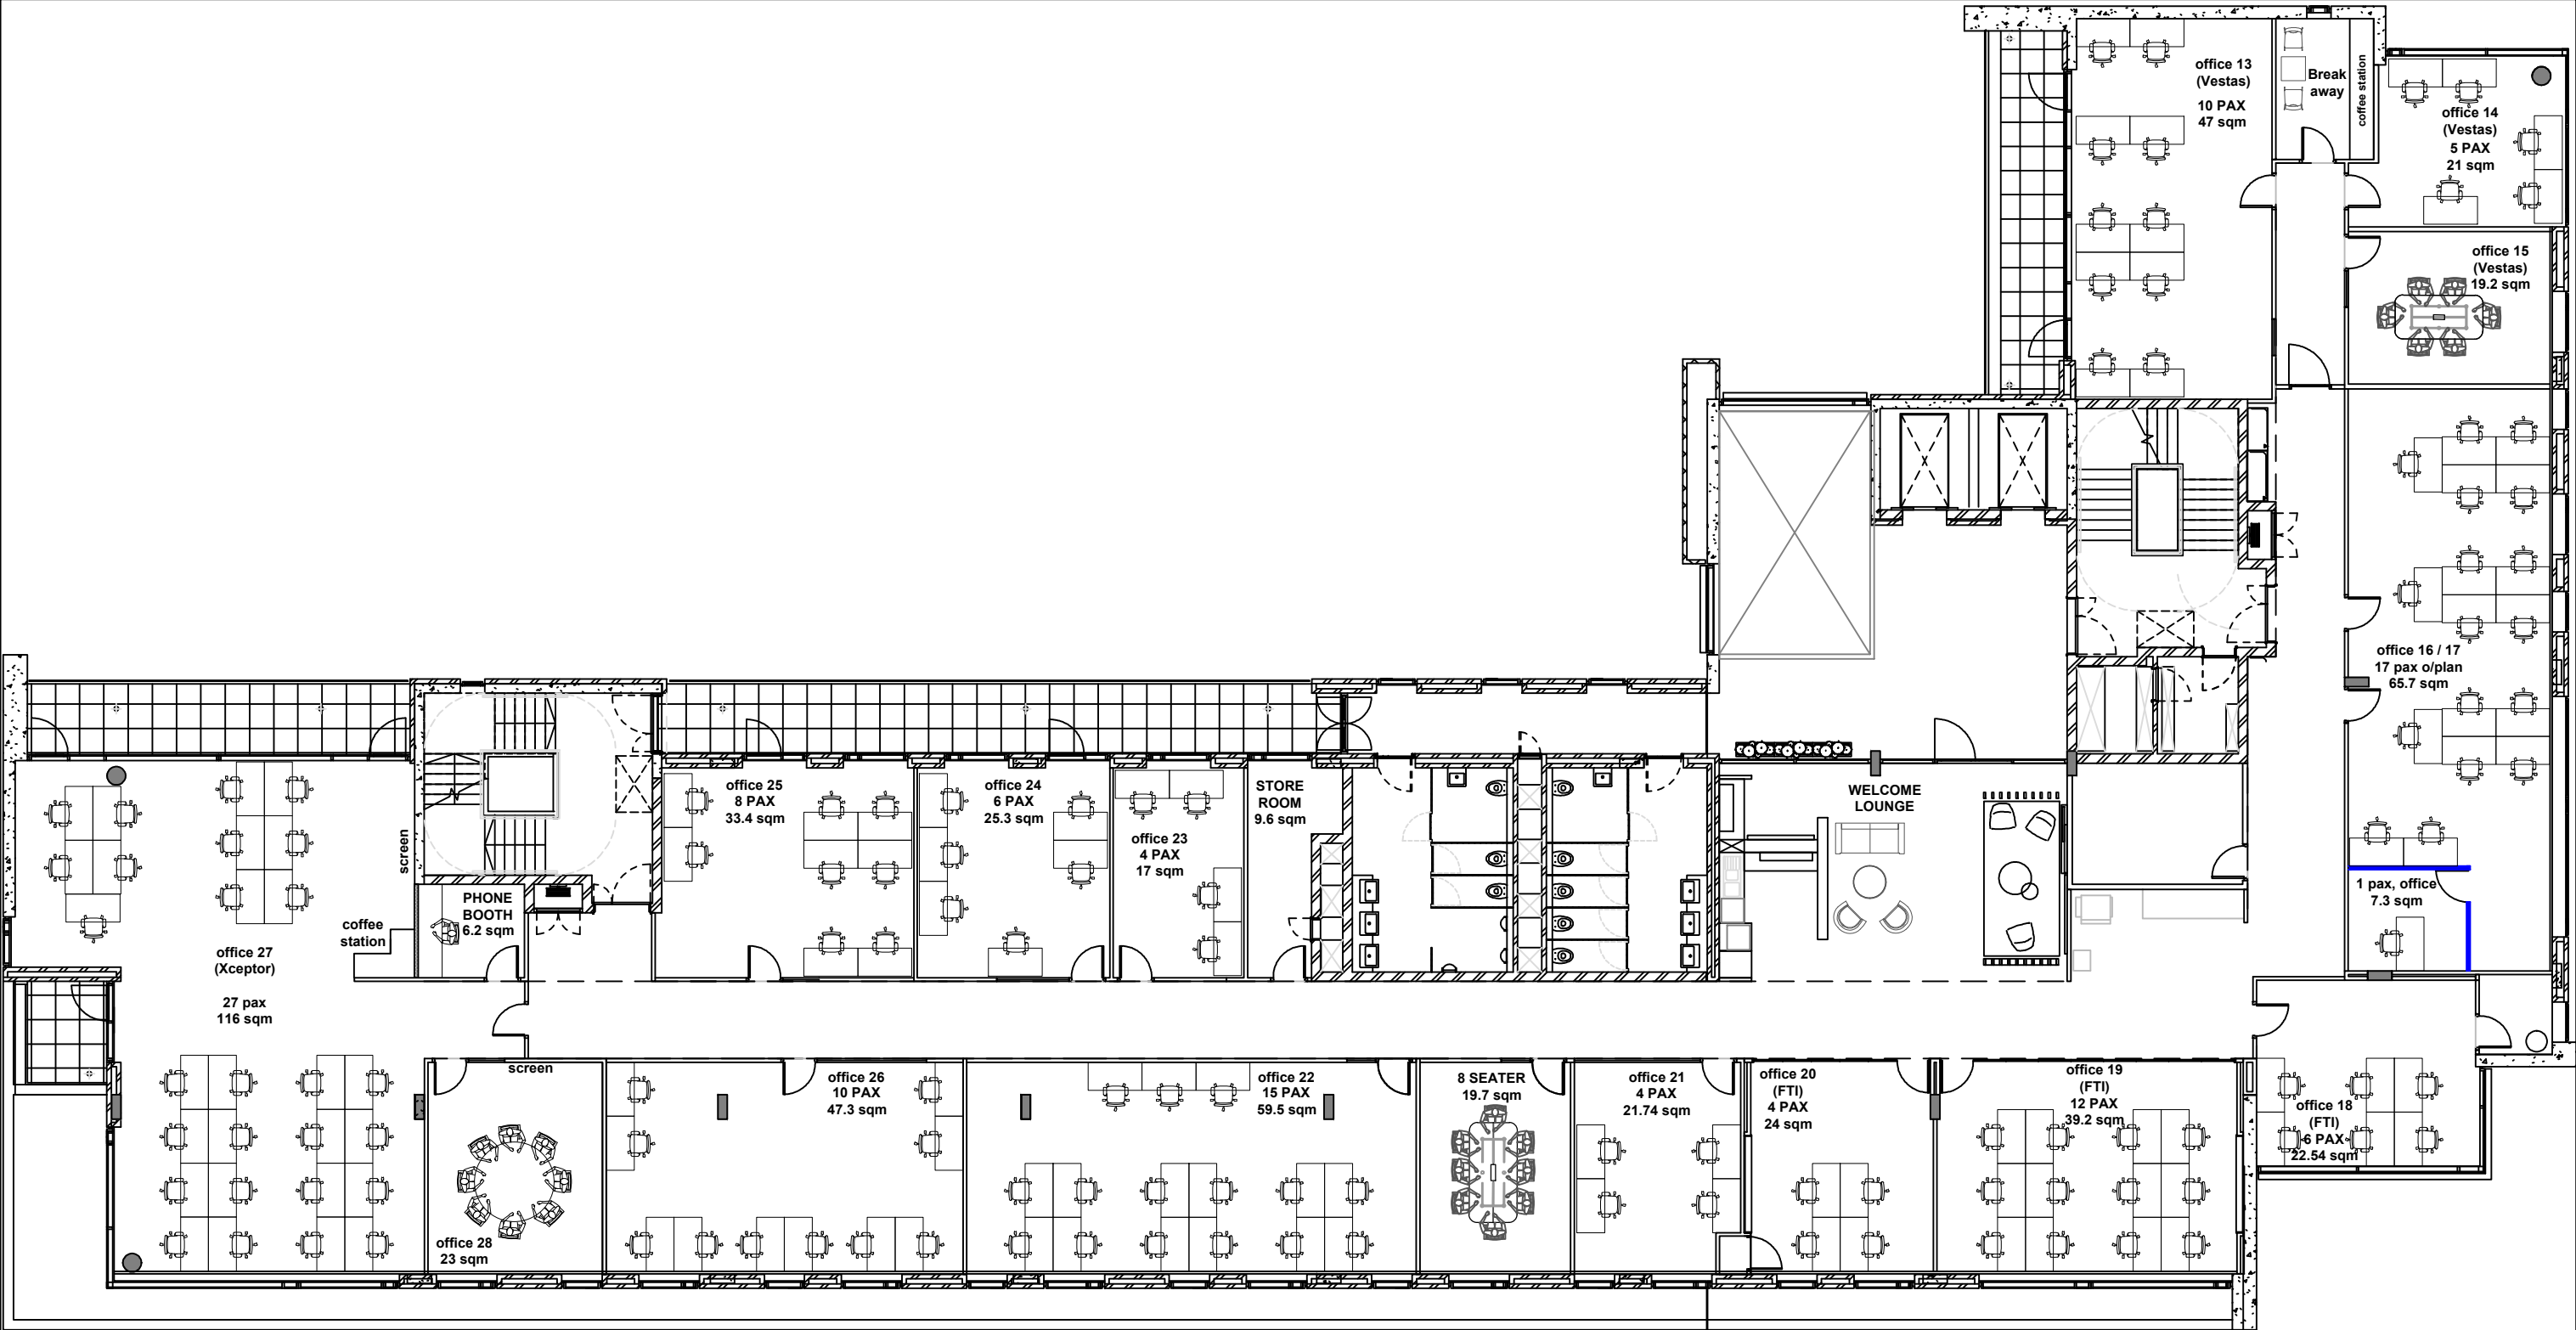

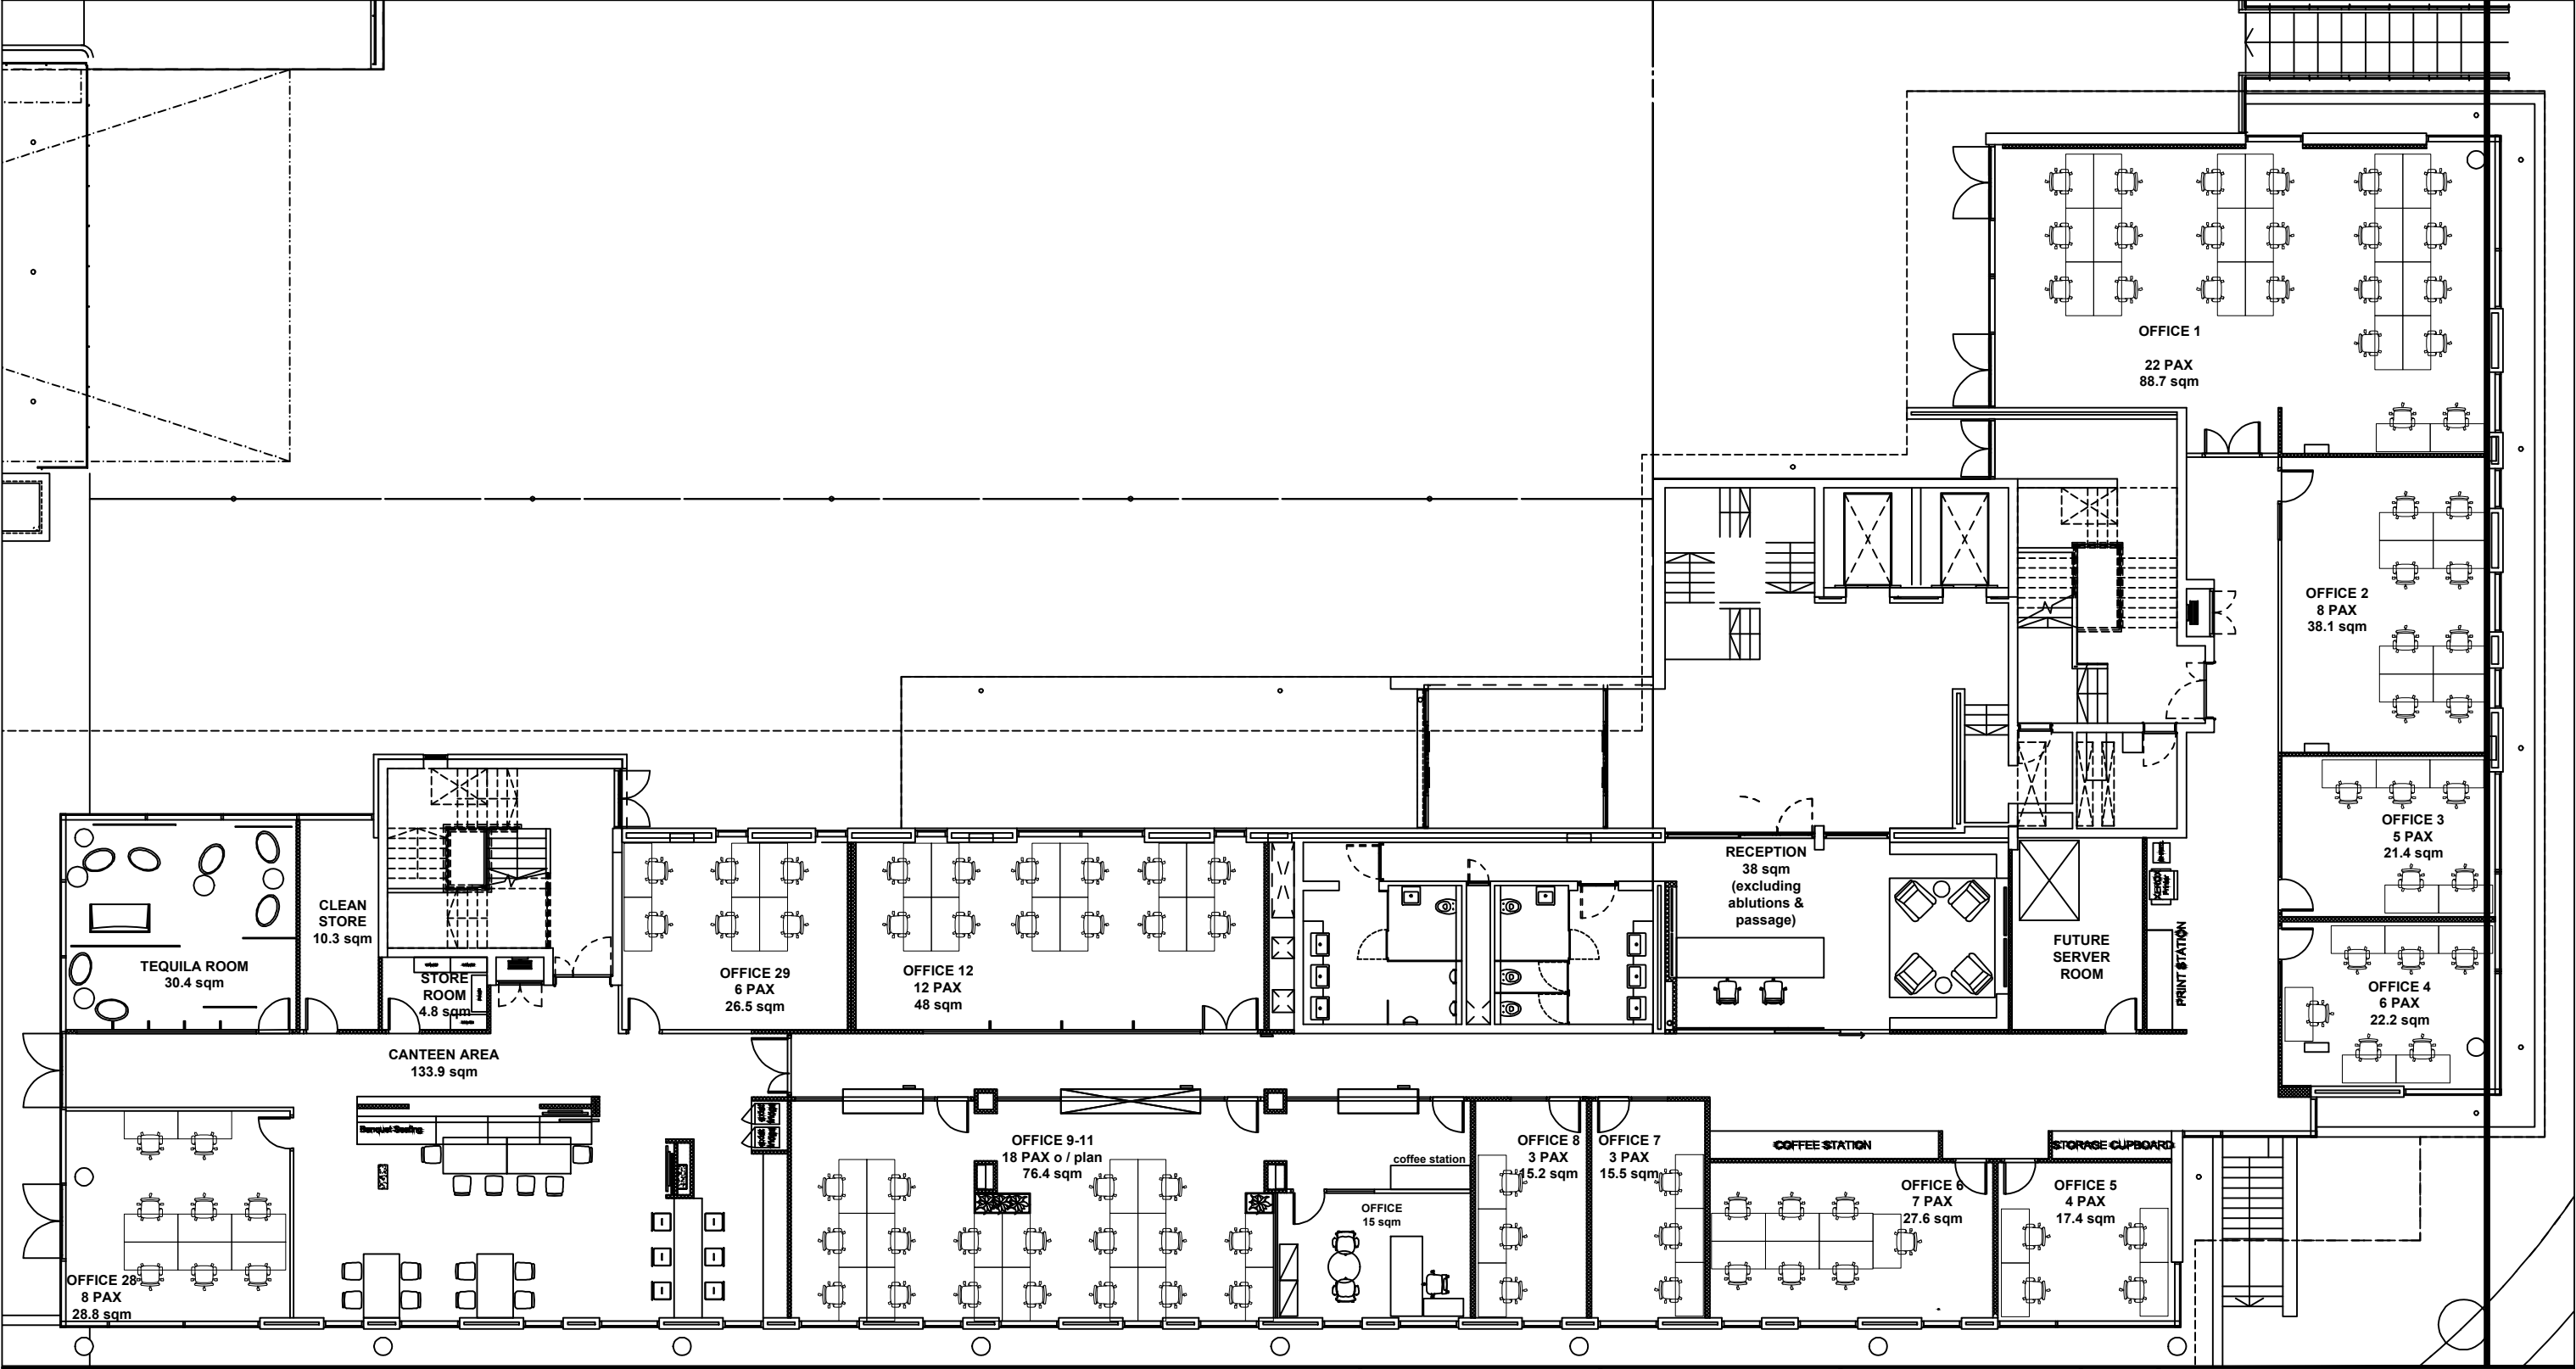

REVISIONS:	
No	DESCRIPTION
01	GENERAL REVISIONS

A3 SHEET = NTS
REV 01: 2025.12.12

CLIENT:

THE BUSINESS EXCHANGE

PROJECT NAME:
TBE CENTURY CITY

INFORMATION

DESIGNED:	CHECKED:	PROJECT NO:
DATE: 19-06-2025	DRAWN: MW	SCALE: A3 @ NTS
DRAWING DESCRIPTION:		
AS BUILT FLOOR LAYOUT		
GROUND FLOOR		

DRAWING NUMBER:	REVISION:
TBE-CC-00-03-AB	01