


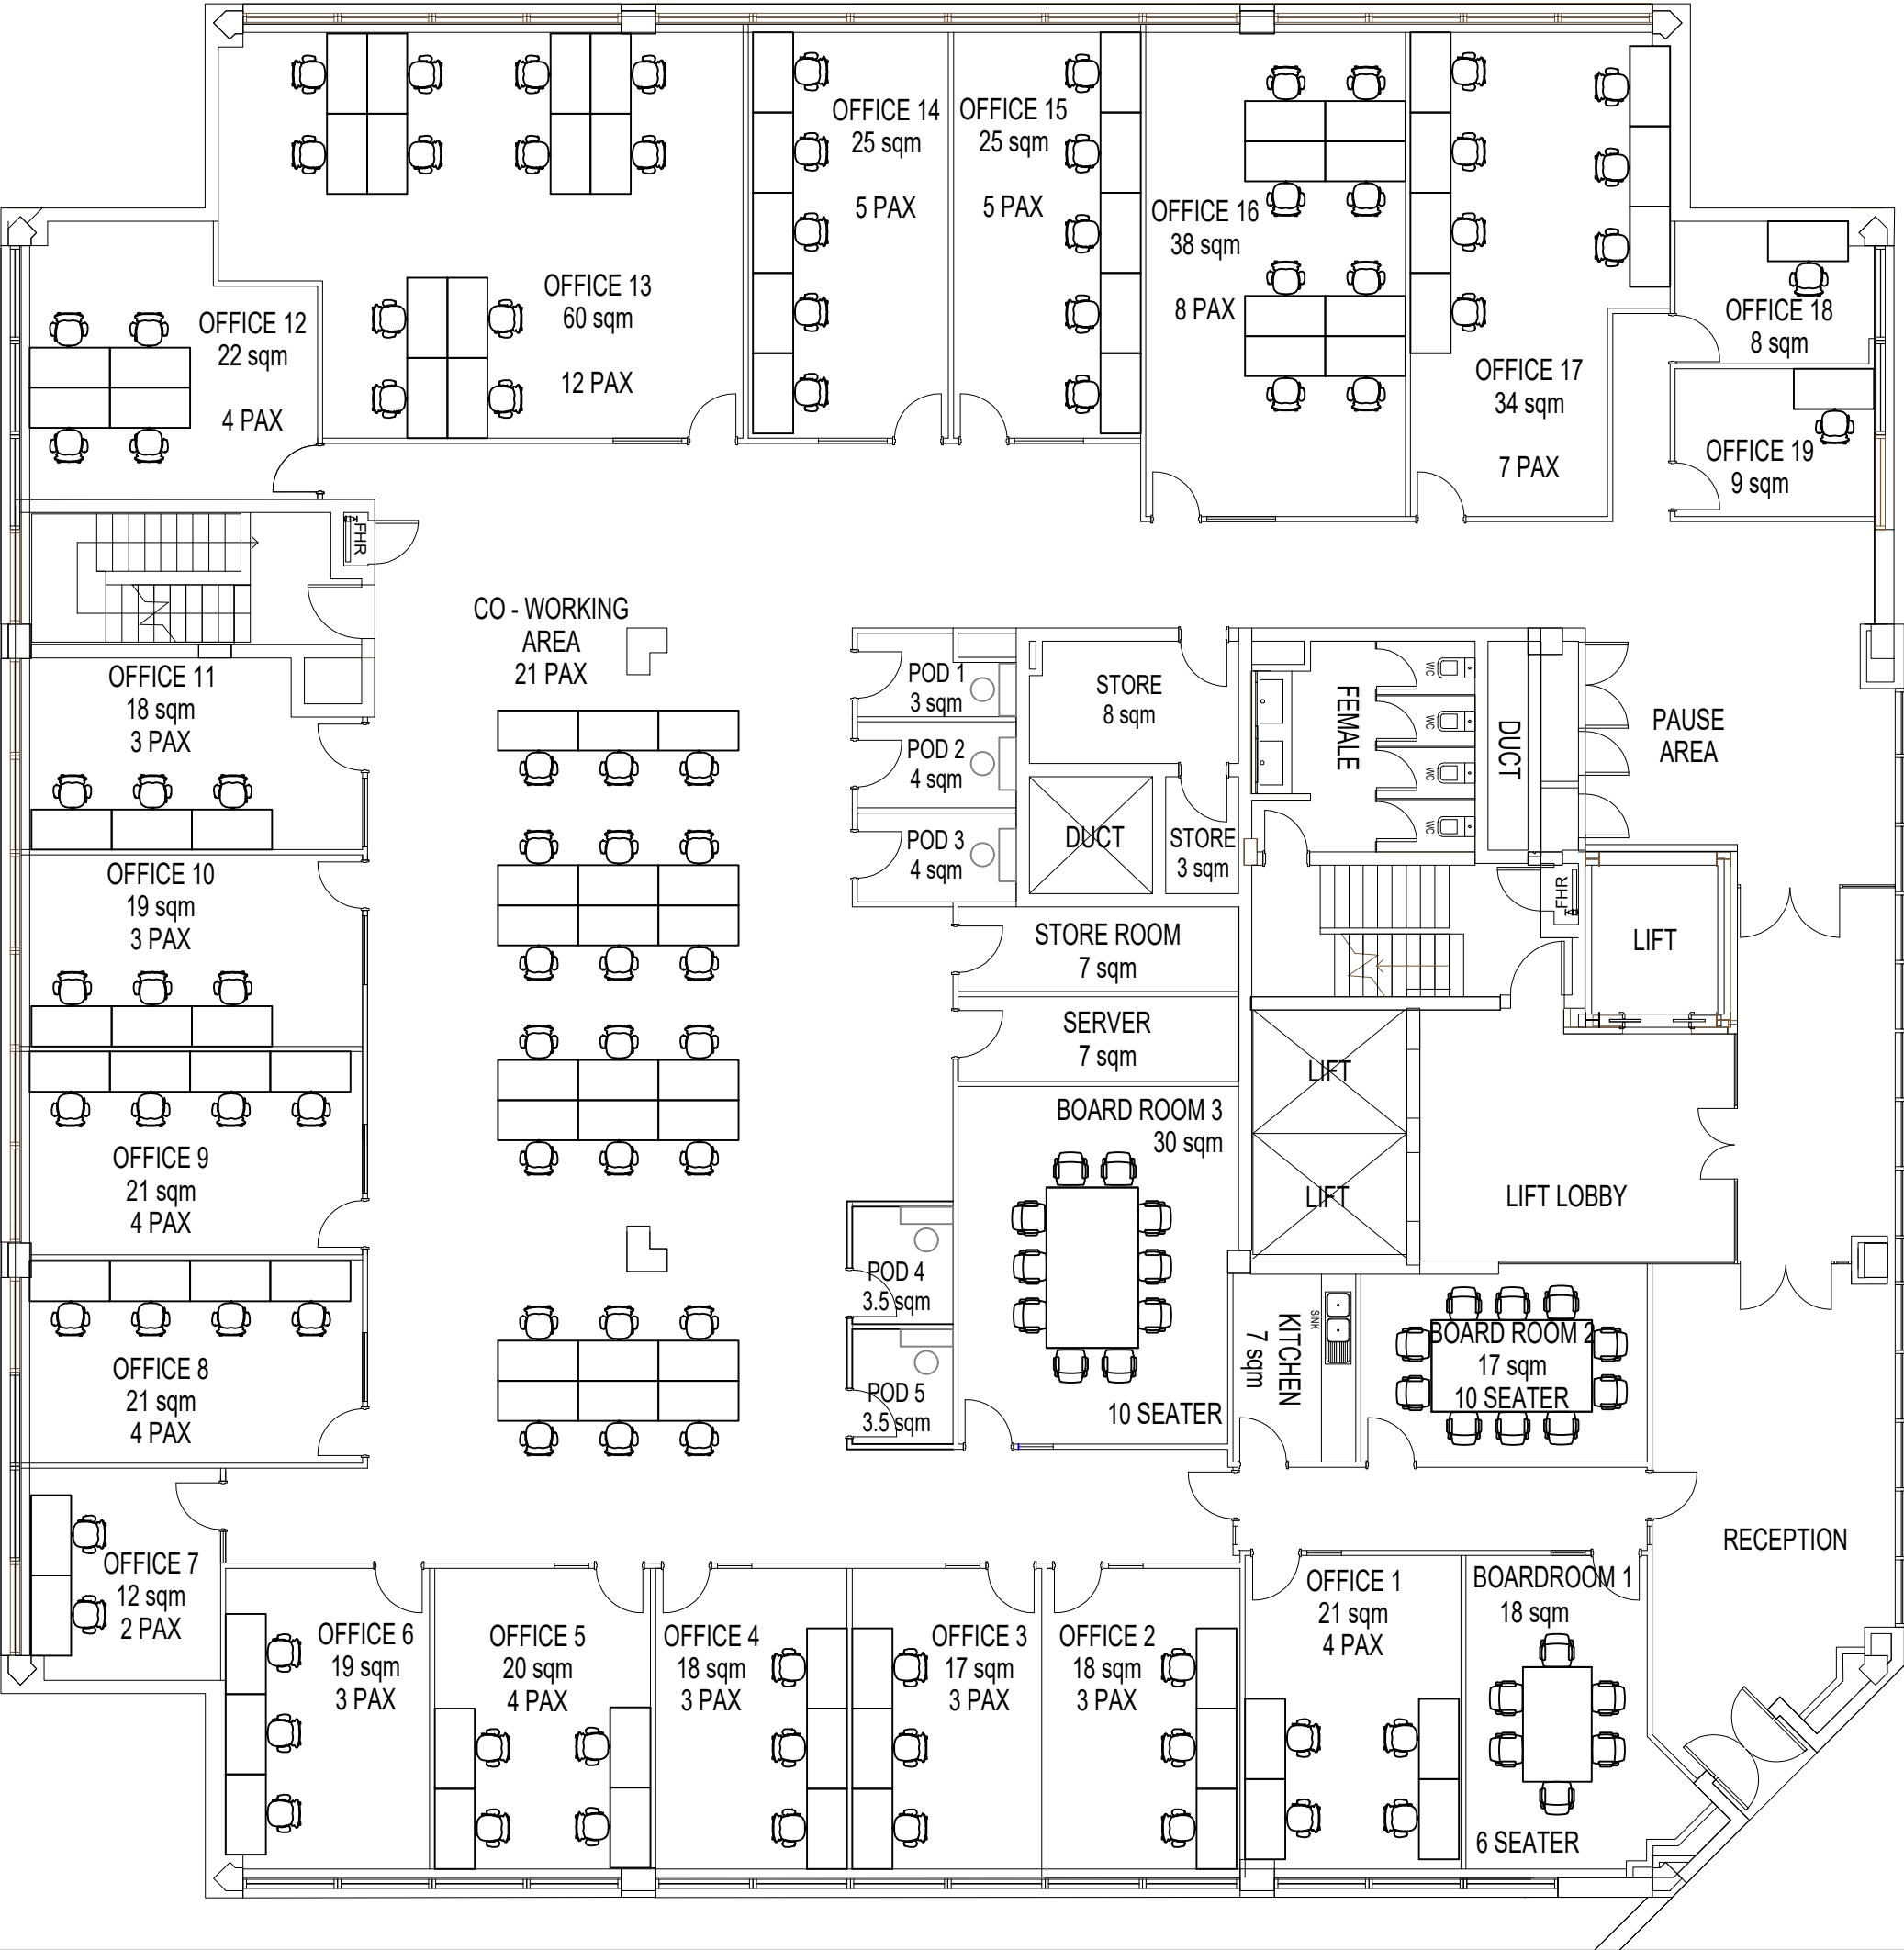

REVISIONS:

No	DATE	DESCRIPTION
01	16.02.26	FLOOR PLAN UPDATED TO AS BUILT

A3 SHEET = NTS
REV 02: 2026.06.22

CLIENT:

THE BUSINESS EXCHANGE

PROJECT NAME:

3 SANDOWN

INFORMATION

DESIGNED:	CHECKED:	PROJECT NO:
DATE: 04-02-2026	DRAWN: MW	SCALE: A3 @ NTS

DRAWING DESCRIPTION:

AS BUILT FLOOR LAYOUT
1ST FLOOR

DRAWING NUMBER: TBE-3SD-01-02-FL	REVISION: 02
-------------------------------------	-----------------